
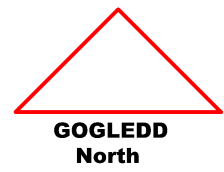


denotes hardcore track

existing ditches and watercourses were untouched during track laying works

where the new tracks cross over the existing ditches a 600mm dia ribbed pipe was installed to cater for the water flow. Pipe surrounded in consolidated hardcore up to the underside of the new track.

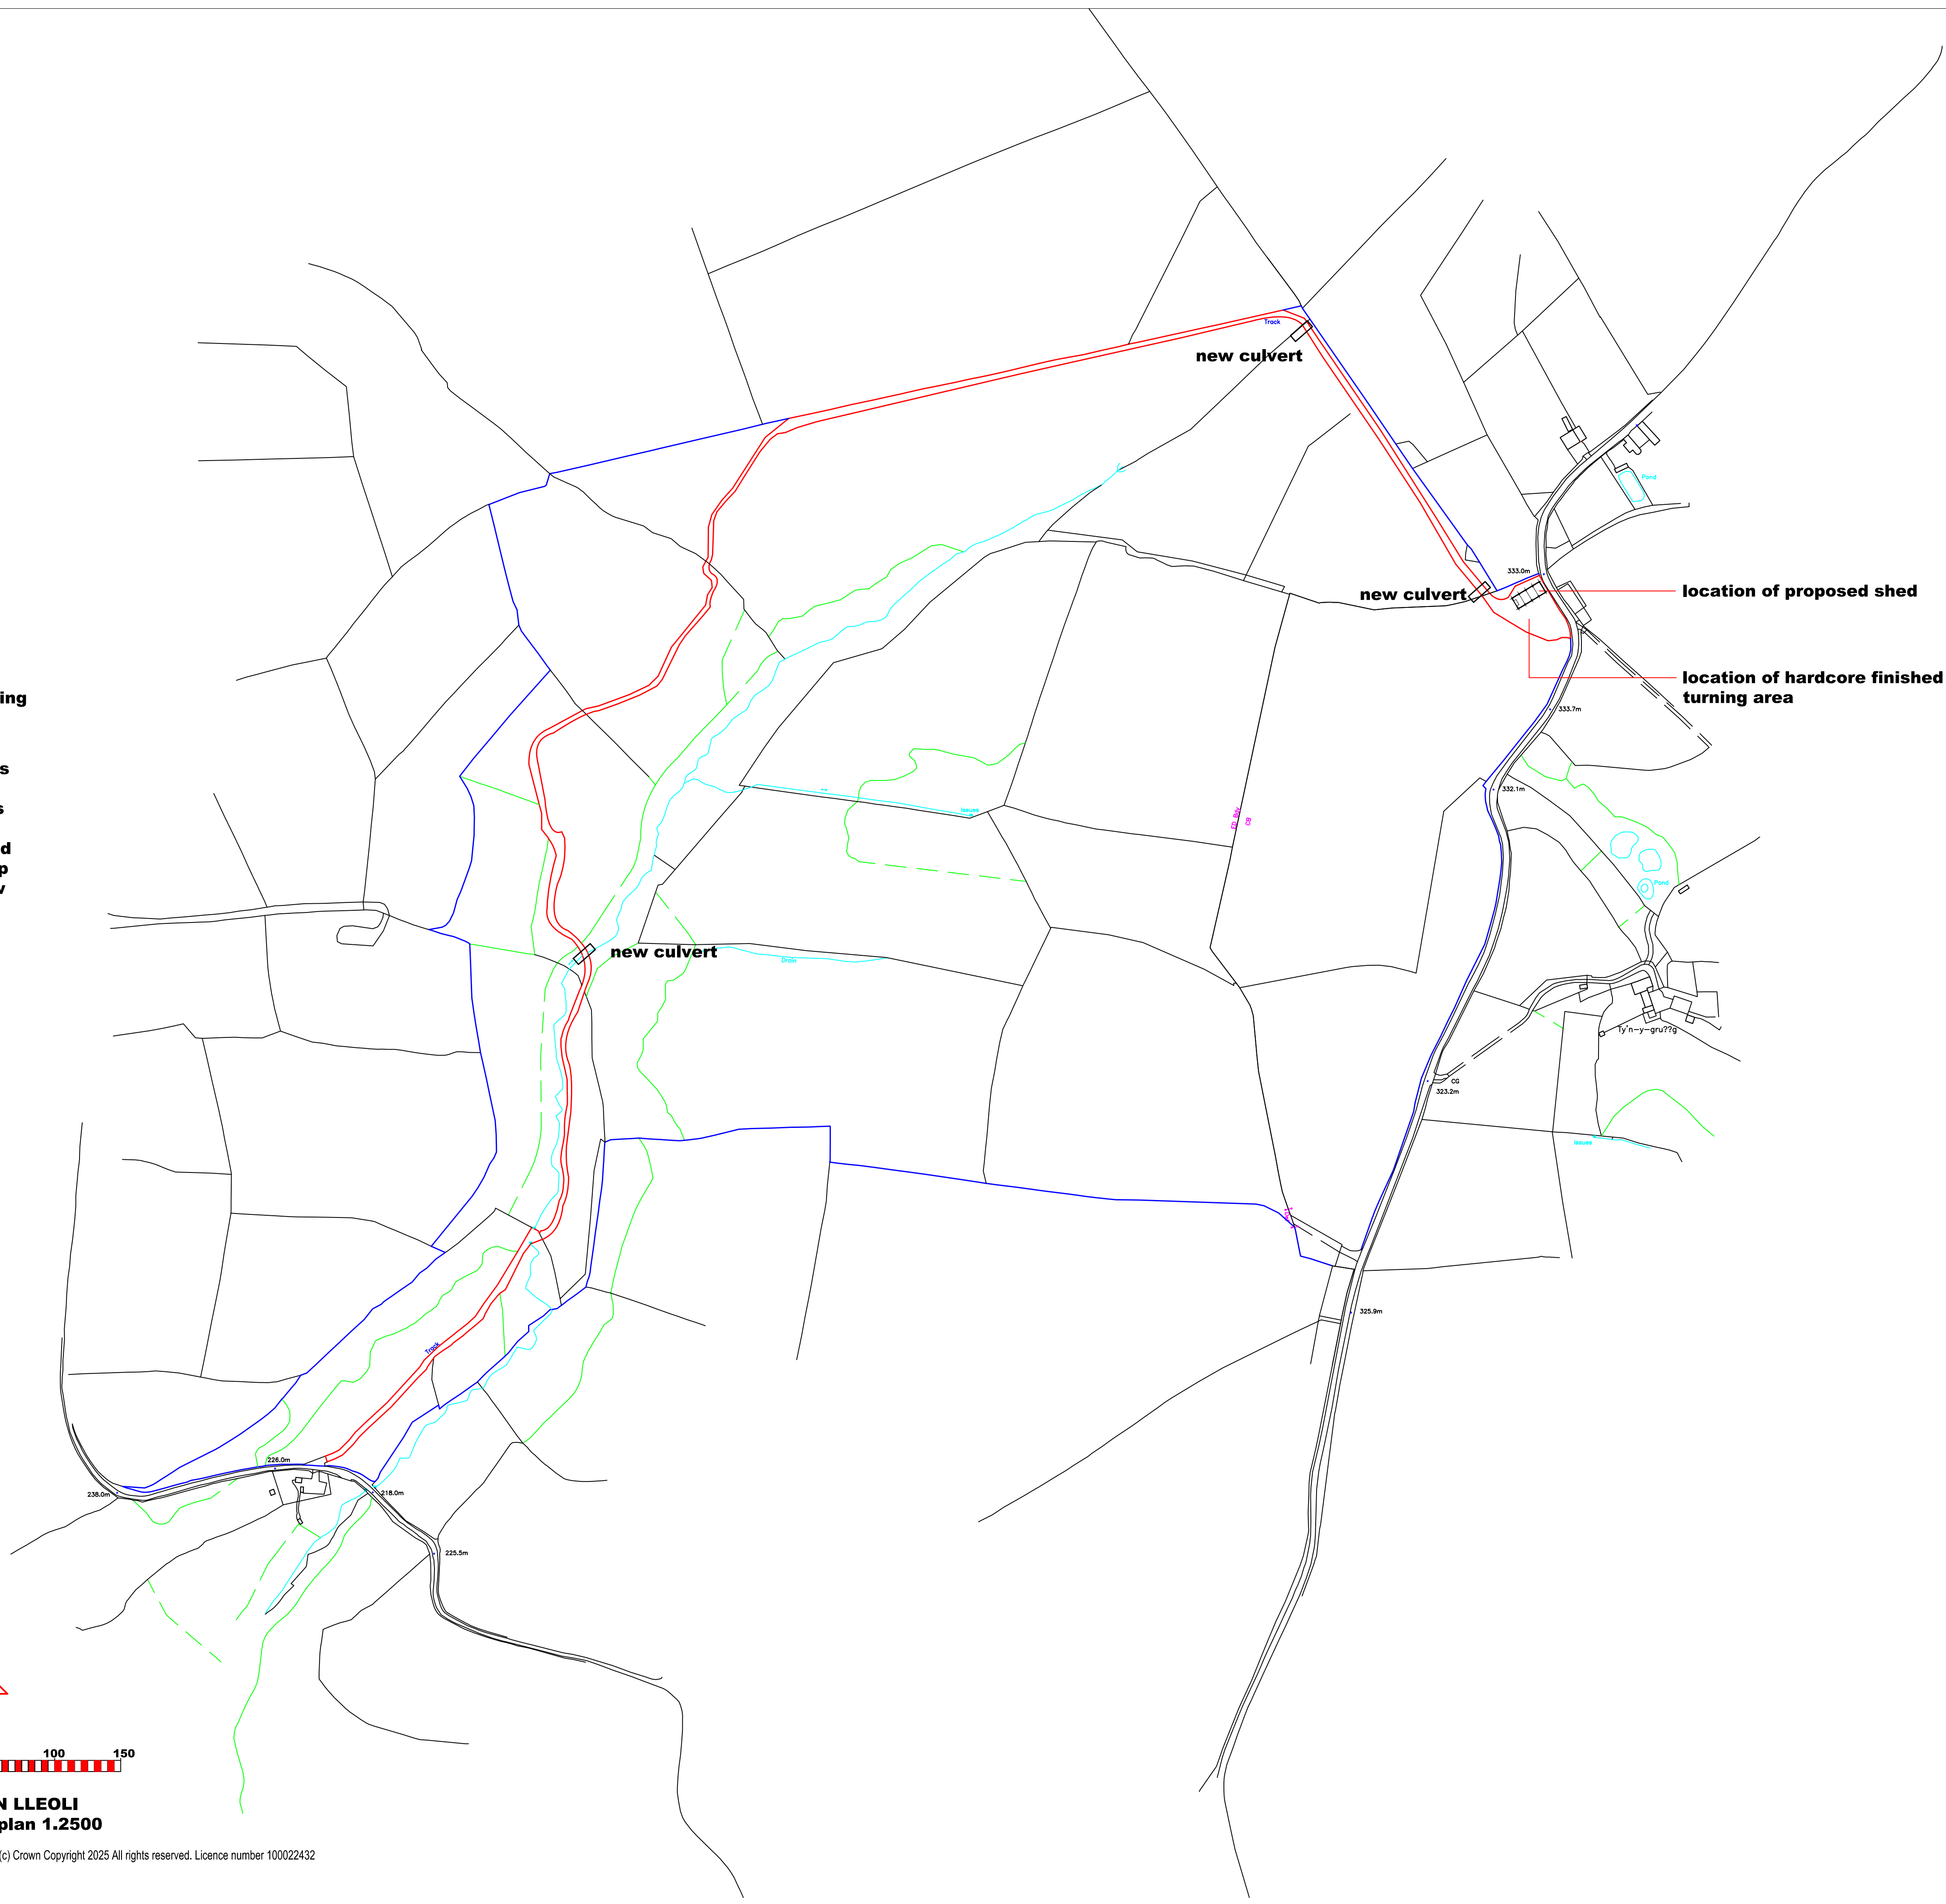

0 50 100 150
M

CYNLLUN LLEOLI
location plan 1.2500

Ordnance Survey, (c) Crown Copyright 2025 All rights reserved. Licence number 100022432

BYRON JENKINS MCIAT,
YMDYNGHORI PENGAERNDOL A BUEGLAETH PROSECTAU,
ARCHITECTURAL CONSULTANCY AND PROJECT MANAGEMENT,
CAPEL AFAN, LLANAFAN, ABERYSTWYTH,
CEREDIGION SY23 4AY
byron@byronjenkins.co.uk
01974 261145
07974 099884

project Mynydd Argoed, Esgairdawe, Lampeter, Ceredigion. SA48 8HE	of 1 calls party to: 658/03
--	---------------------------------------

drawn 1:2500 @ A1	checked Rhag 2025	drawn byron
----------------------	----------------------	----------------