




EDRYCHIAD BLAEN
front elevation 1.100

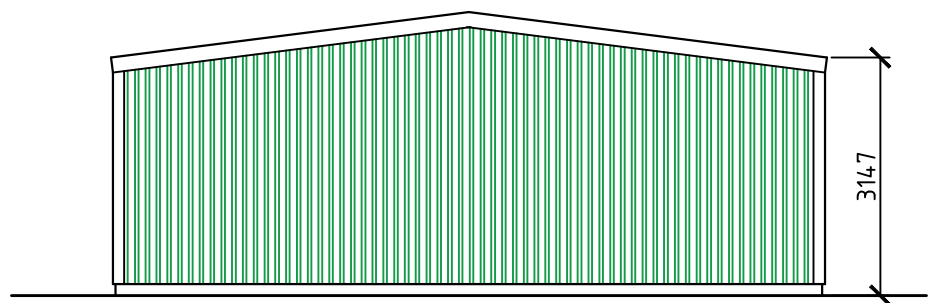


EDRYCHIAD CEFN
rear elevation 1.100

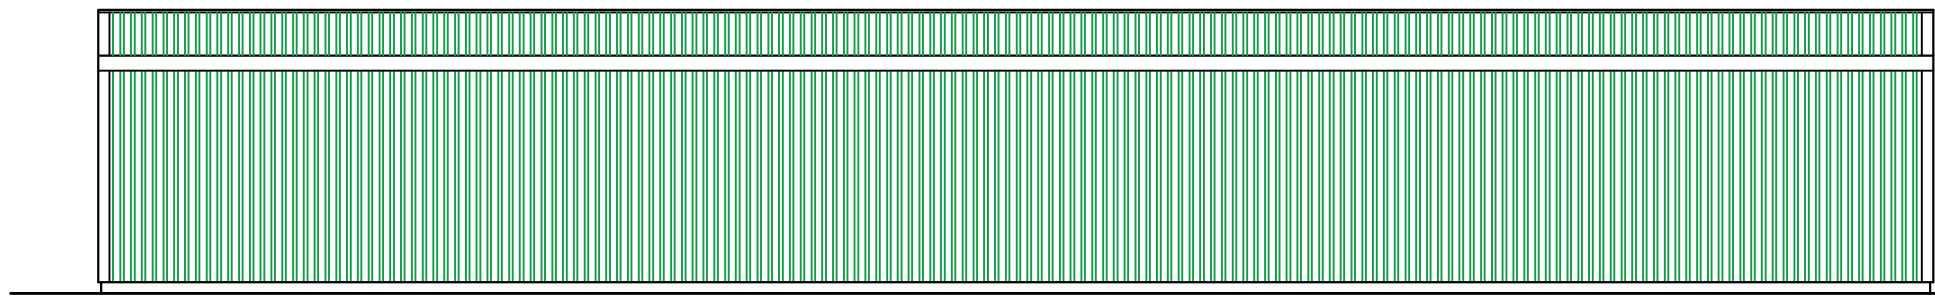



EDRYCHIAD OCHR
side elevation 1.100

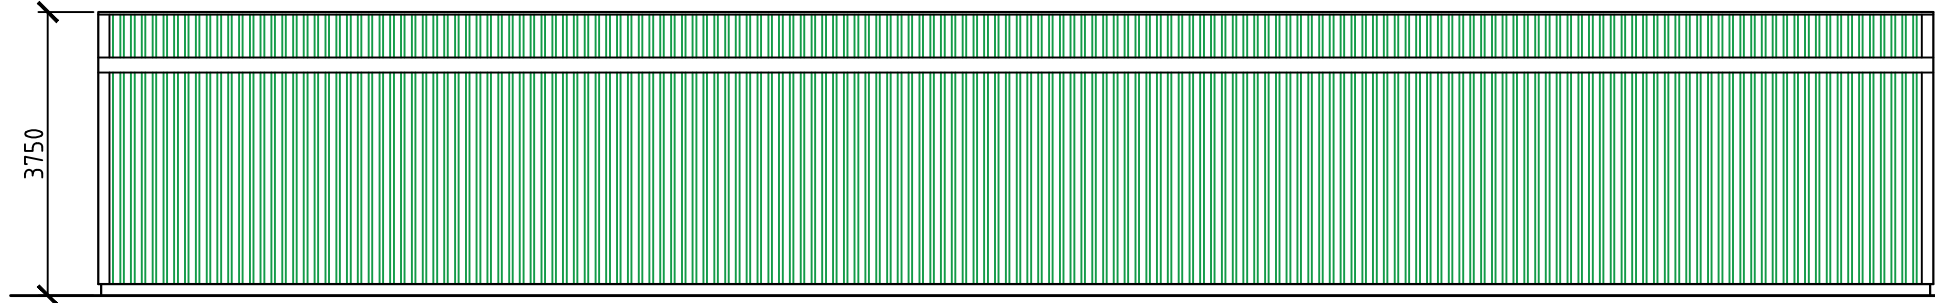



EDRYCHIAD OCHR
side elevation 1.100

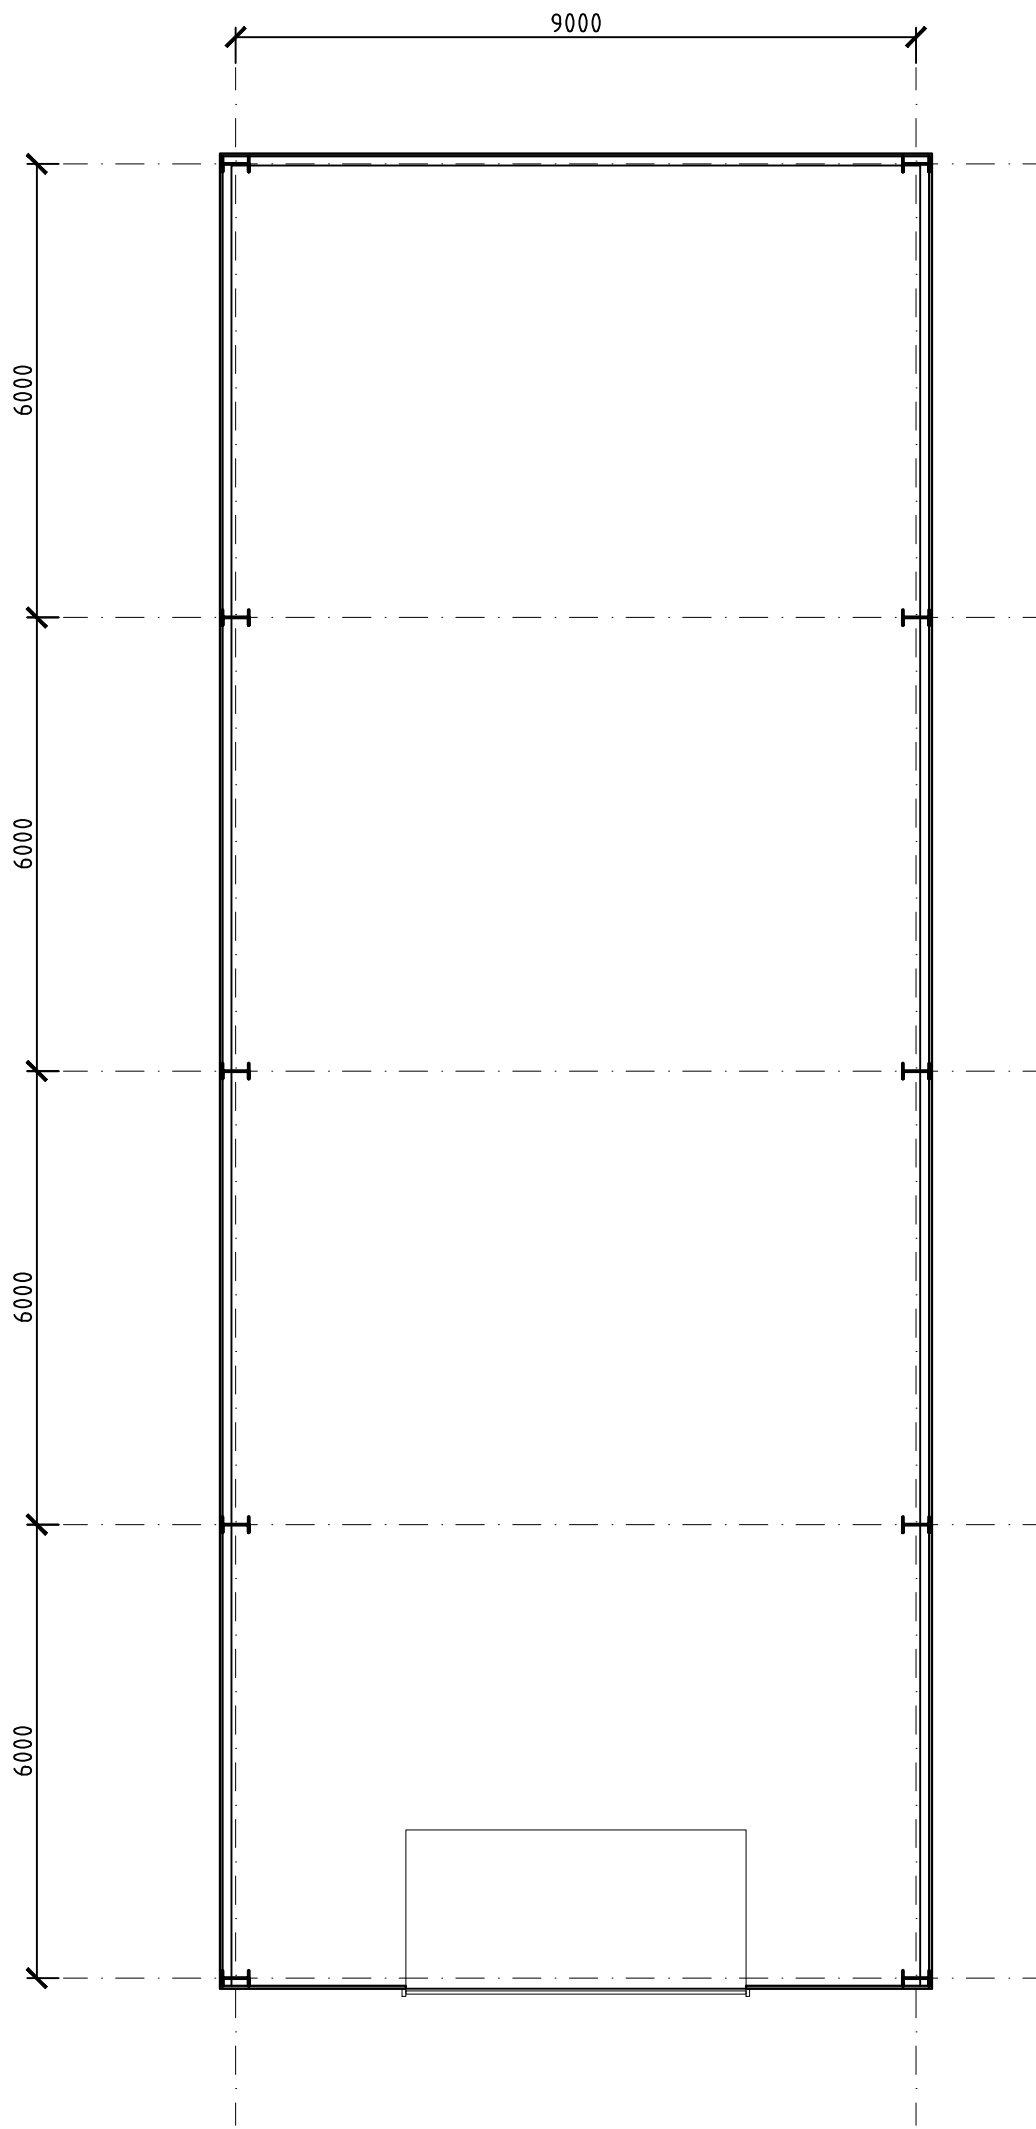


CYNLLUN
plan 1.100

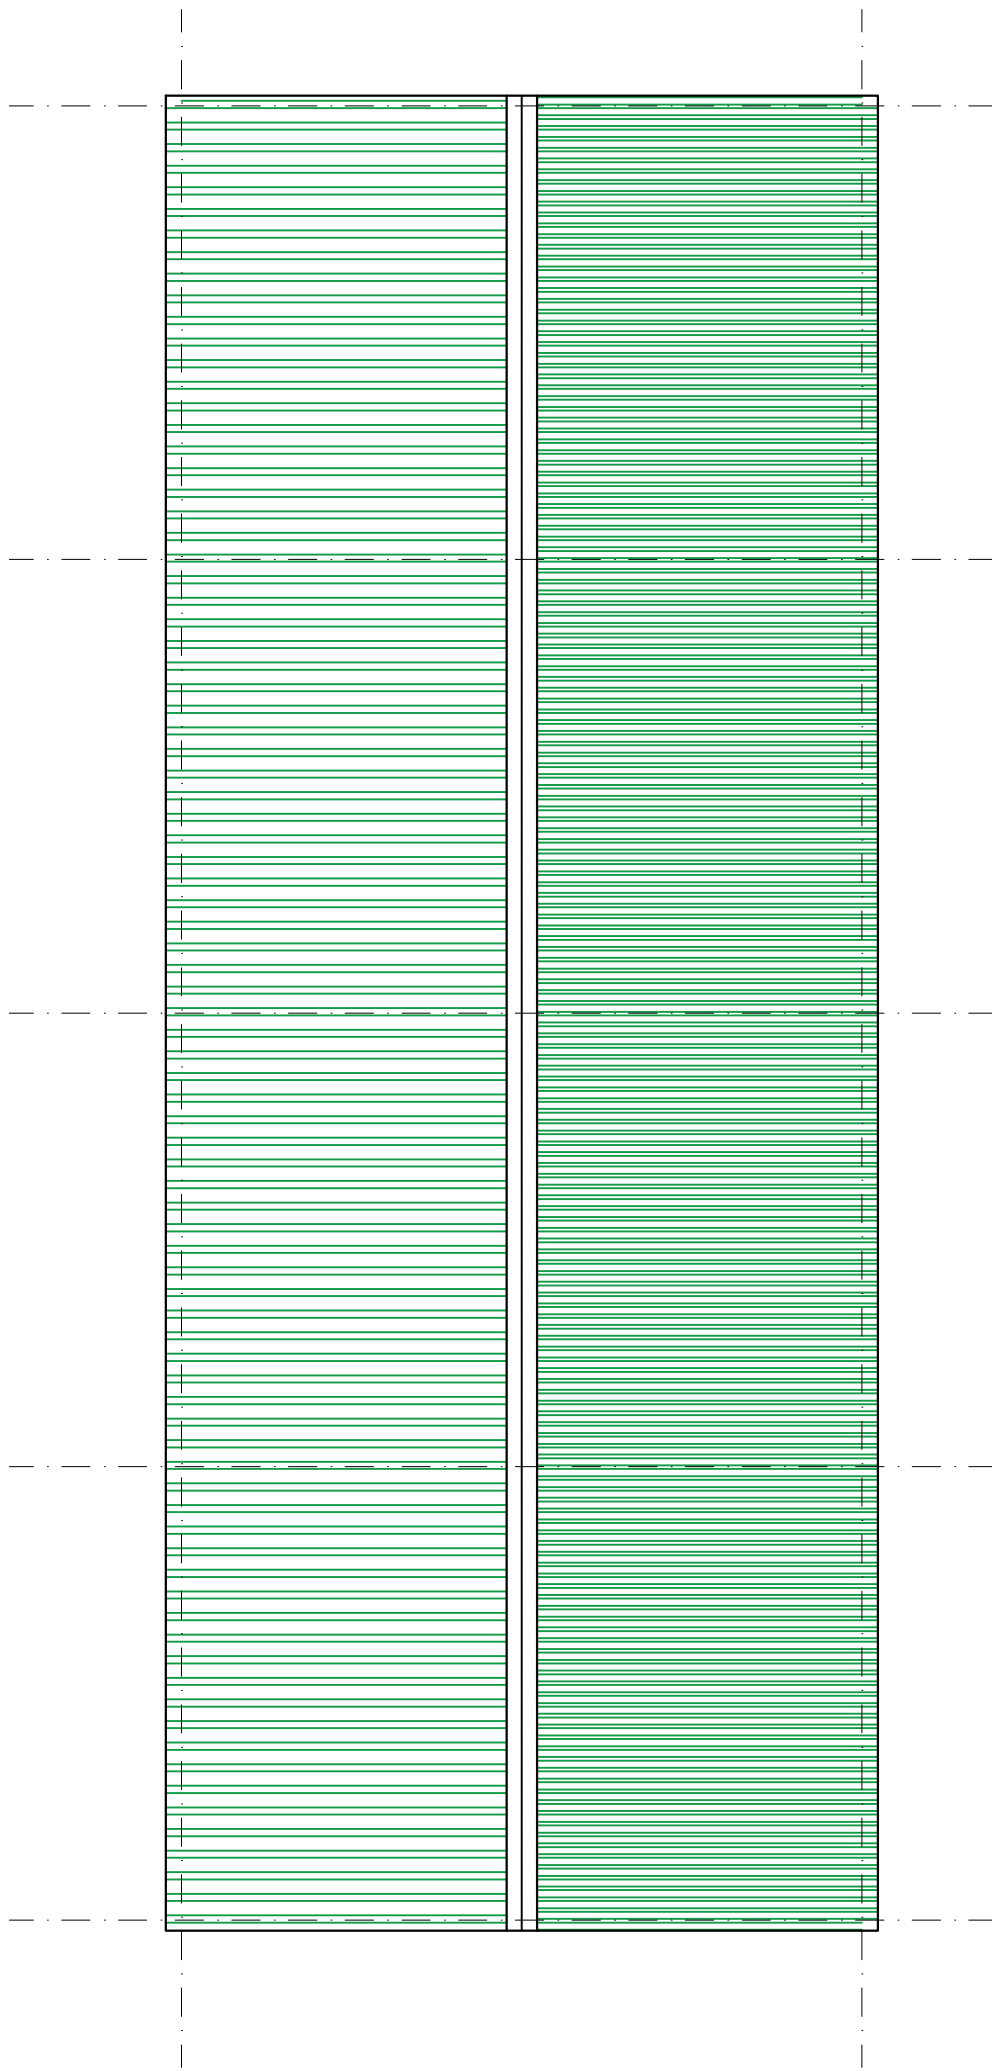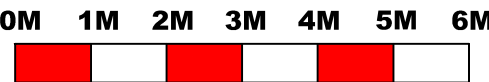

CYNLLUN Y TO
roof plan 1.100

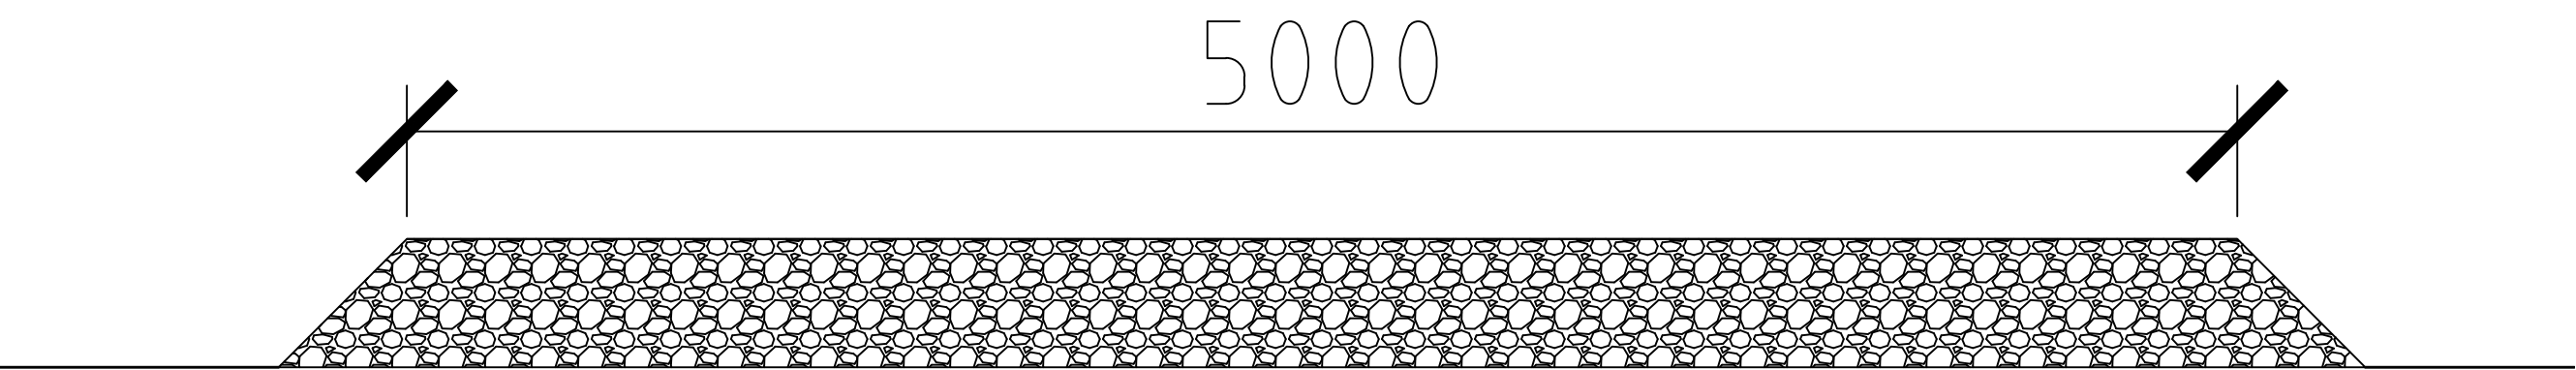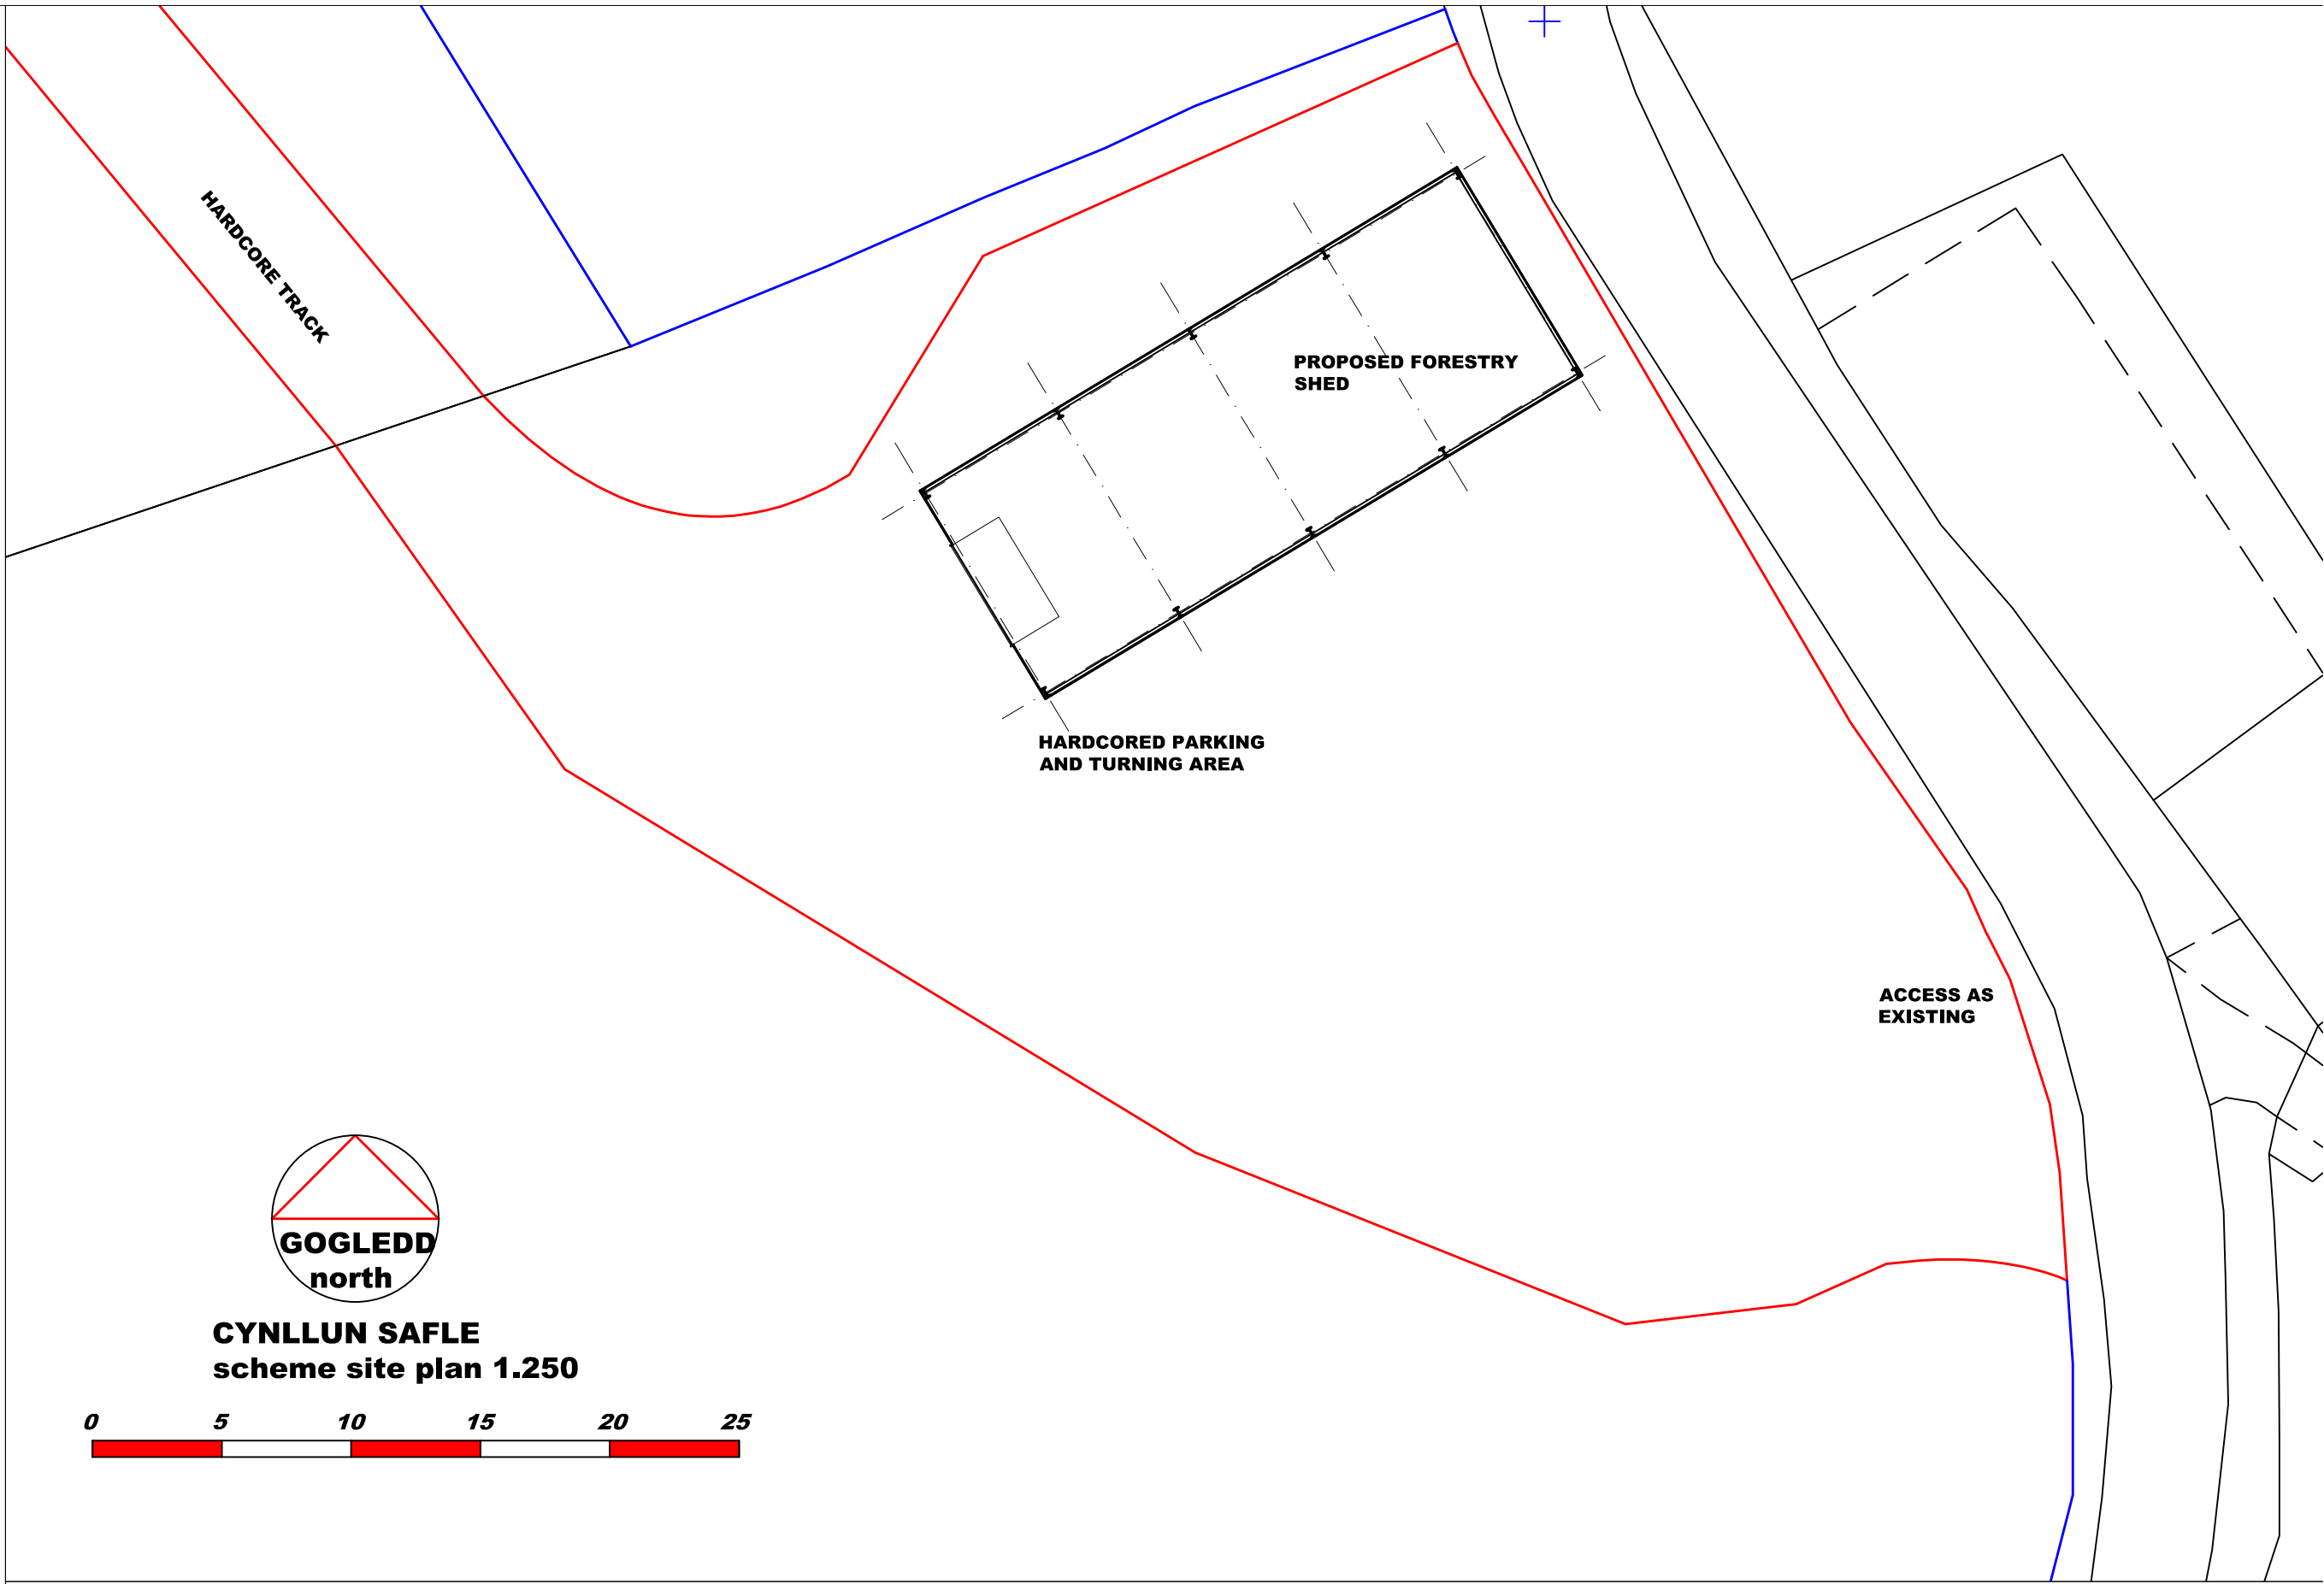

Typical section through the track 1.20

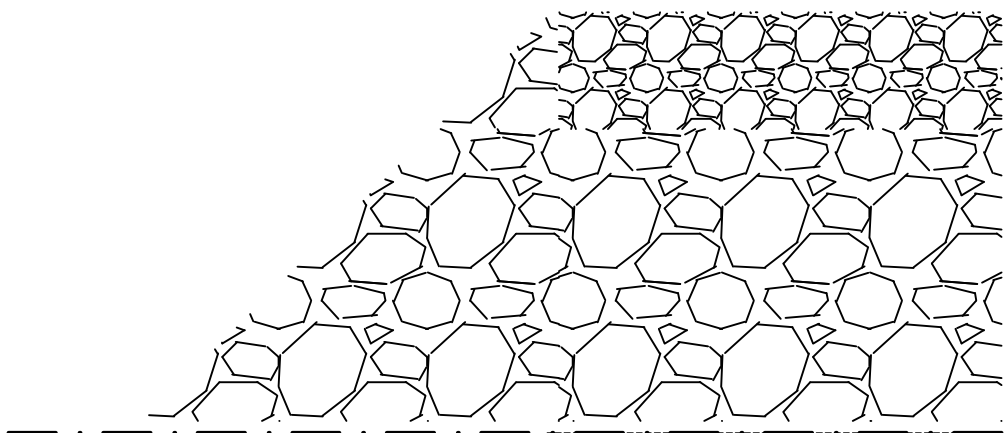

PARKING AND TURNING AREA and TRACK SPECIFICATION.

BYRON JENKINS

MCiAT,

YMDYNGHORI PENGAERNDOL A RHEDLAETH PROSECTADL

ARCHITECTURAL CONSULTANCY AND PROJECT MANAGEMENT,

CAPEL AFAN, LLANAFAN, ABERYSTWYTH,

CEREDIGION SY23 4AY

byron@byronjenkins.co.uk

01974 261145

07974 099884

project

Mynydd Argoed,

Esgairdawe,

Lampeter,

Ceredigion.

SA48 8HE

job no.

CYNLLUN MESUR

survey drawing

CYNLLUN SAFLE

site plan

as built drawing

of 2 copies

658/02

drawn

1.2500 @ A1

checked

Gorff 2025

drawn by

byron